Alberta This plan may not be commercially re-distributed, transferred or manipulated in any form without the specific written consent of Alberta Land Titles

882 2999

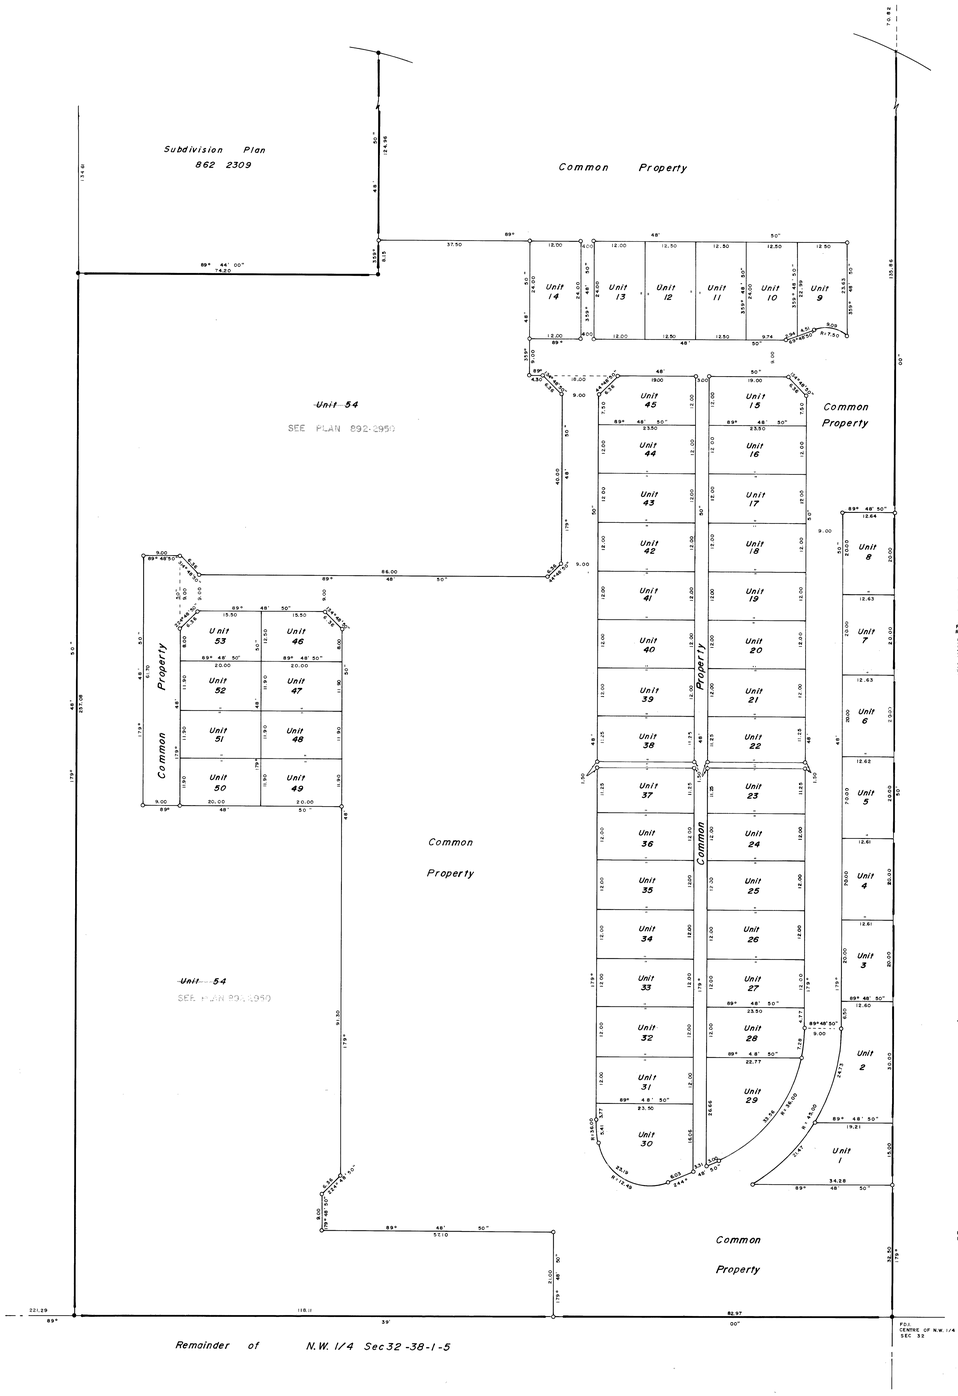

Unit Number	Unit Factor	Total Area in M² (Approx)	Unit Number	Unit Factor	Total Area in M² (Approx)
1	86	383	28	86	280
2	86	428	29	86	409
3	86	252	30	86	412
4	86	252	31	86	282
5	86	252	32	86	282
6	86	253	33	86	282
7	86	253	34	86	282
8	86	253	35	86	282
9	86	273	36	86	282
10	86	299	37	86	264
11	86	300	38	86	264
12	86	300	39	86	282
13	86	288	40	86	282
14	86	288	41	86	282
15	86	272	42	86	282
16	86	282	43	86	282
17	86	282	44	86	282
18	86	282	45	86	272
19	86	282	46	86	240
20	86	282	47	86	238
21	86	282	48	86	238
22	86	264	49	86	238
23	86	264	50	86	238
24	86	282	51	86	238
25	86	282	52	86	238
26	86	282	53	86	240
27	86	282	~~54~~	~~544.2~~	~~49,169~~
			Total	10,000	

FOR UNIT 54
REDIVISION PLAN 892 2950

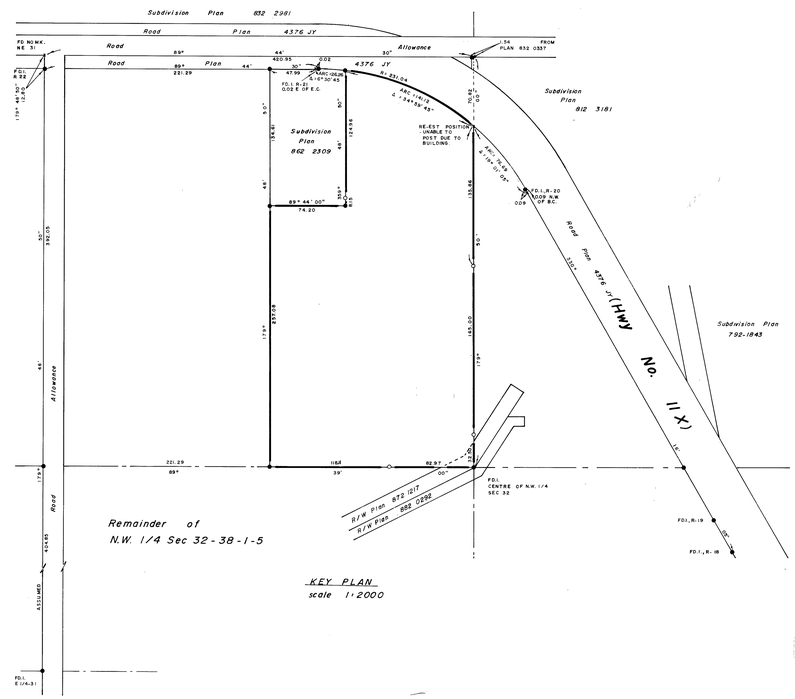

KEY PLAN
scale 1:2000

SHEET 1 OF 1

NOTE:
FOR ANY ENDORSEMENT, REGISTRATION MEMORIAL, NOTIFICATION OR OTHER ENTRY THAT IS TO BE MADE UPON THE PLAN PLEASE USE SHEET 2 WHICH IS ISSUED TO THIS PLAN PURSUANT TO THE CONDOMINIUM PROPERTY ACT REGULATIONS.
DATED DEC 12 19 88
A. D. REGISTRAR

Land Titles

PLAN No. 8822999
ENTERED AND REGISTERED
ON DEC 12 88
INSTRUMENT No. 882297359
A.D. REGISTRAR

Director of Surveys

SURVEY APPROVED
DIRECTOR OF SURVEYS
DATE APPROVED 88-12-07
EXD. GF FILE 121577
APPROVED VALID FOR TWELVE MONTHS.

RED DEER REGIONAL PLANNING COMMISSION

APPROVED SUBJECT to the FOLLOWING CONDITIONS
Easements Registration
of the Easement for Access.
RED DEER REGIONAL PLANNING COMMISSION
SECTY.
DATE Nov 10 19 88
THIS APPROVAL IS EFFECTIVE FOR A PERIOD OF 1 YEAR FROM DATE OF THIS ENDORSEMENT
B/o 194-5-91/88
193-7-91/88
87/88 R52
32/2750

Reserve not required pursuant to section 23 of the Planning Act
The Red Deer Regional Planning Commission.

POINTS WEST RESORTS

BARE LAND CONDOMINIUM PLAN

Of Part Of

N.W. 1/4 Sec 32-Twp 38-Rge 1-W5M.

County of Red Deer No. 23

By: M. Young, A.L.S., 1988

Scale: 1:500

0 50 100 200 300 400 500

Legend

- Statutory Iron Posts found are shown thus ●
- Statutory Iron Posts planted are shown thus ○ and are marked P090
- Temporary points established are shown thus ×
- Outside corner iron bars are planted at all Unit corners unless otherwise shown
- Dimensions are in metres and decimals there of.
- Distances on curve boundaries are Arc lengths
- The boundary of any Unit is governed by the monuments placed pursuant to the Surveys Act.
- Area referred to is outlined thus ———— and contains 6.60Ha.

Surveyors Affidavit

I, M. Young of the City of Red Deer, Alberta Land Surveyor, make oath and say:
1. That the survey represented by this plan was made under my personal supervision,
2. That the survey was made in accordance with good surveying practices and in accordance with the provisions of the Surveys Act and
3. That the surveyors performed between the dates of April 5 and May 17, A.D. 1988 and that this plan is true and correct and is prepared in accordance with the provisions of the Condominium Property Act and the Land Titles Act.

Sworn before me at the City of Red Deer in the Province of Alberta, this 11 day of Oct A.D. 1988.

A Commissioner for Oaths in and for the Province of Alberta.
GLENDA VAN GAAL
Expiry Date: March 15, 1990

Alberta Land Surveyor

ALBERTA LAND SURVEYORS ASSOCIATION
P090
BEMOCO LAND SURVEYING LTD.

Signatures

Registered Owner
Points West Resorts Inc.

Seal

Condominium Corporation Address
21-7895-49th Avenue
Red Deer, Alta
T4P 2B4

County of Red Deer No. 23

Seal

Drawn by - D.G	Bemoco Land Surveying Ltd. 21-7895-49th Avenue Red Deer, Alberta. 343-2611	File - S-056-86
Checked by - JvS		
Date - 19 May 1988.		

882 2999

882 2999